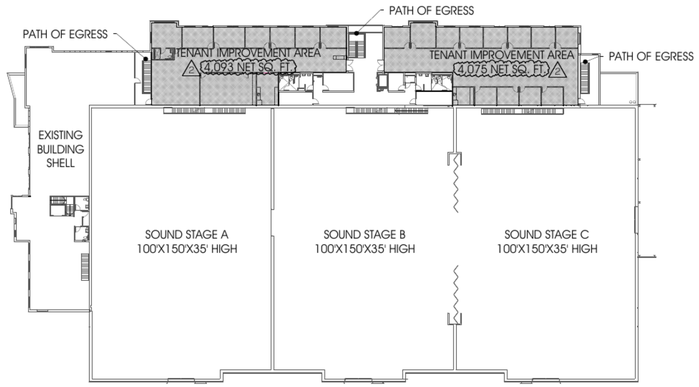


TENANT IMPROVEMENT
REFERENCE PLAN - LEVEL 02 C2
1" = 40'-0" AE102

## KEYED NOTES:

| | |
|---|---|
| 1 | ALUMINUM STOREFRONT SYSTEM; SEE WINDOW TYPES & FINISH LEGEND |
| 2 | ALL WALLS ABOVE STOREFRONT SYSTEM TO BE 6" METAL STUD FRAMING W/ 5/8" GYP. BOARD TO DECK (TYPE 'S' TYP.) |
| 3 | EXPOSED STRUCTURAL STEEL; PAINT |
| 4 | EXISTING EGRESS DOOR W/ PANIC HARDWARE |
| 5 | EXISTING BUILDING SHELL SEMI-RECESSED FIRE EXTINGUISHER CABINET |
| 6 | ROOF DRAIN PIPING; PAINT |
| 7 | SEMI-RECESSED FIRE EXTINGUISHER CABINET |
| 8 | RECEPTION DESK; SEE ELEVATIONS & DETAILS ON AE550 |
| 9 | TENANT PROVIDED COPIER EQUIPMENT; SEE ELECTRICAL FOR POWER & DATA INFORMATION |

**FINISH NOTE: ALL FLOORS TO BE SEALED CONCRETE - CS (U.N.O.)
ALL WALLS TO BE PAINTED - PT 1 (U.N.O.)
SEE FINISH LEGEND AE601

## GENERAL NOTES:

- SEE SHEET AE001 FOR GENERAL NOTES.
- SEE TITLE SHEET FOR DRAWING INDEX.
- DO NOT SCALE DRAWINGS.
- CONTRACTOR / SUBCONTRACTOR SHALL VERIFY ALL DIMENSIONS AND CONDITIONS BEFORE BEGINNING WORK, AND SHALL REPORT TO THE ARCHITECT ANY ERRORS, INCONSISTENCIES OR OMISSIONS BEFORE BEGINNING WORK. SEE GENERAL NOTES AND SPECIFICATIONS.




LEVEL 02 - TENANT FLOOR PLAN A4/AE102
1/8" = 1'-0"

0' 4' 8' 16' 24'
SCALE : 1/8" = 1'-0"

ARCHITECT 1334.09
ajc architects
703 east 1700 south
salt lake city, utah 84105
ph: 801.466.8818
fx: 801.466.4411
www.ajcarchitects.com

CONSULTANT

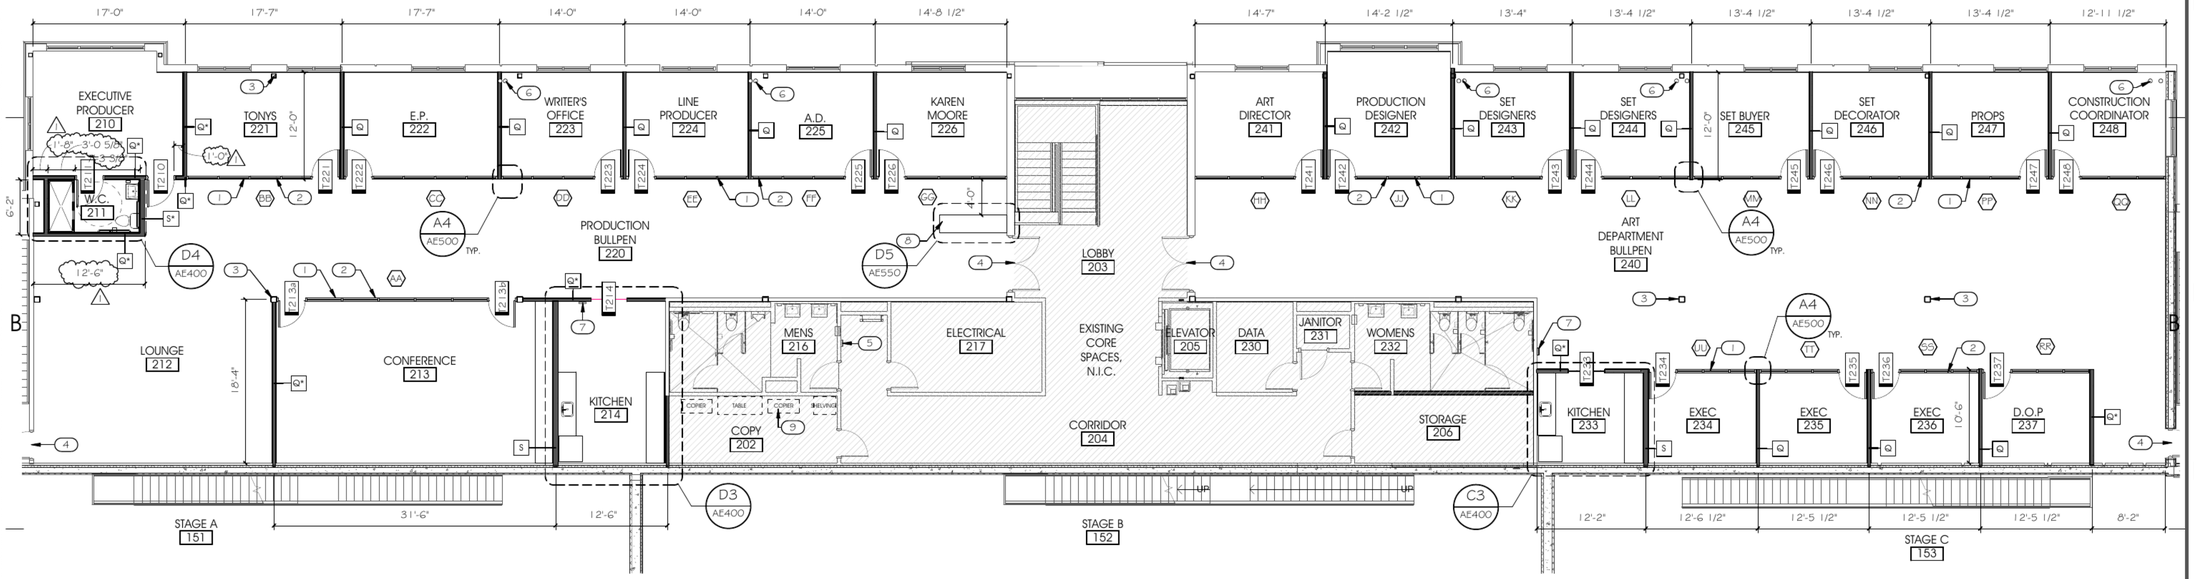STATE OF UTAH · KENT R. RIGBY · 135096 · LICENSED ARCHITECT · 6/24/15

OWNER INFORMATION

PROJECT DESCRIPTION

PARK CITY FILM STUDIOS TENANT IMPROVEMENT

4001 KEARNS BLVD
PARK CITY, UT 84060

SHEET NAME:

TENANT FLOOR PLAN - LEVEL 2

REVISIONS

| MARK | DATE | DESCRIPTION |
|---|---|---|
| 1 | 06/30/15 | ASI #1 |
| 2 | 07/02/15 | CITY REVIEW COMMENTS |

ISSUE DATA

| | |
|---|---|
| ISSUE DATE: | JUNE 25, 2015 |
| ISSUE TYPE: | CON DOC |
| DRAWN BY: | AK / RM |
| CHECKED BY: | K. Rigby |

SHEET NUMBER:

AE102

ALL IDEAS, DESIGNS, ARRANGEMENTS AND PLANS INDICATED, OR REPRESENTED, BY THIS DRAWING ARE OWNED BY AND THE PROPERTY OF AJC ARCHITECTS PC, AND WERE CREATED, EVOLVED, AND DEVELOPED FOR USE ON AND IN CONNECTION WITH THE SPECIFIED PROJECT. NONE OF THE IDEAS, DESIGNS, ARRANGEMENTS OR PLANS SHALL BE USED BY OR DISCLOSED TO ANY PERSON, FIRM, OR CORPORATION FOR ANY PURPOSE WHATSOEVER WITHOUT WRITTEN CONSENT OF AJC ARCHITECTS PC. WRITTEN DIMENSIONS ON THESE DRAWINGS SHALL HAVE PRECEDENCE OVER SCALED DIMENSIONS. CONTRACTORS SHALL VERIFY AND BE RESPONSIBLE FOR ALL DIMENSIONS AND CONDITIONS ON THE JOB, AND THIS OFFICE MUST BE NOTIFIED OF ANY VARIATION FROM THE DIMENSIONS AND CONDITIONS SHOWN BY THESE DRAWINGS. WARNING: REPRODUCTION HEREOF IS A CRIMINAL OFFENSE UNDER 18 U.S.C. SEC. 1504, 17 U.S.C. SEC. 506, 17 U.S.C. SEC. 1202 AND OTHER LAWS.

7/6/2015 2:47:06 PM P:\13001\1334 PC Film Studio\1334.09 - ABC\Park City Film 7B - ABC 11.rvt